


N/F
Commonwealth of Pennsylvania
DBV 866 PG 720
Tax Map No. 37-88-18L3


N/F
Commonwealth of Pennsylvania

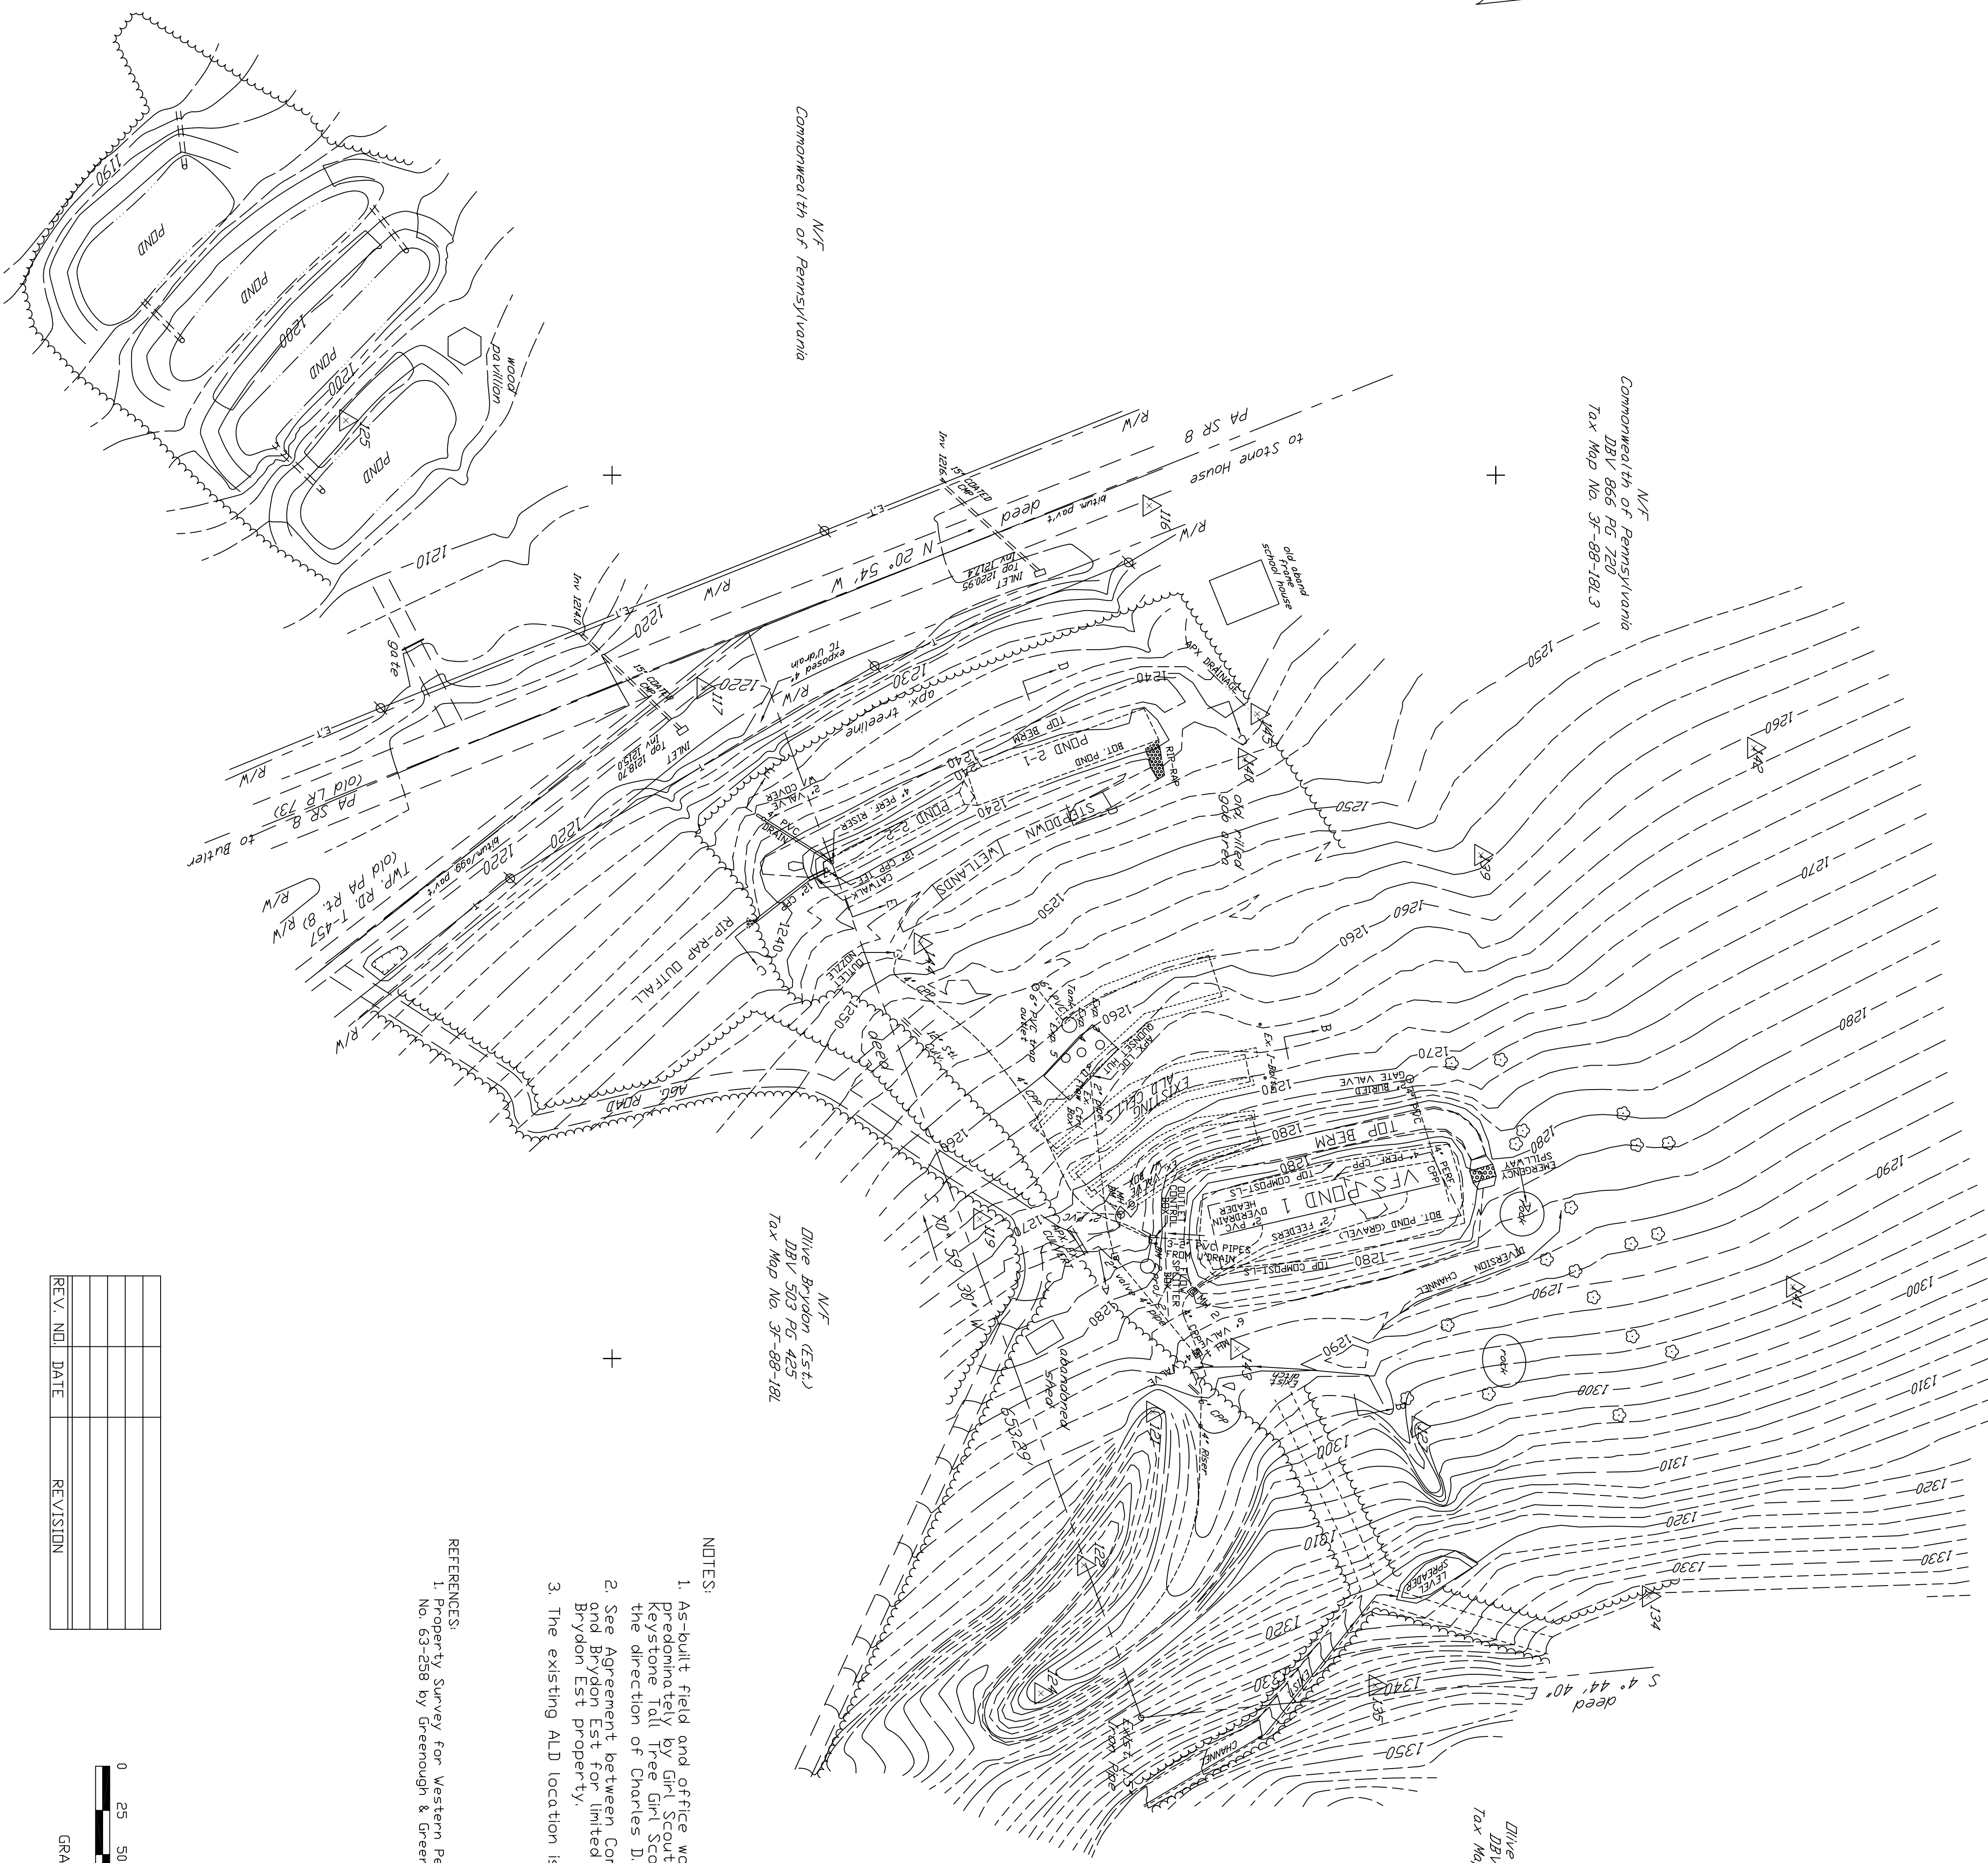

N/F
Dive Brydon (Est.)
DBV 503 PG 425
Tax Map No. 37-88-18L

N/F
Dive Brydon (Est.)
DBV 503 PG 425
Tax Map No. 37-88-18L

REV. NO.	DATE	REVISION

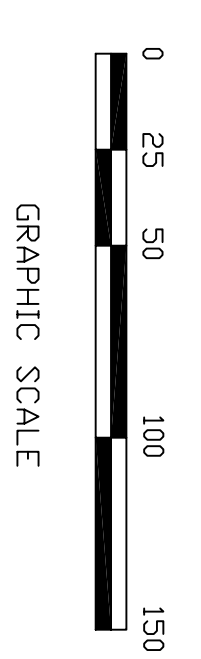

- NOTES:**
1. As-built field and office work performed predominately by Girl Scouts of the Keystone Tall Tree Girl Scout Council under the direction of Charles D. Cooper, P.E., P.L.S.
 2. See Agreement between Comm. of Pennsylvania and Brydon Est. for limited use of Brydon Est. property.
 3. The existing ALD location is approx. and not an as-built.



REFERENCES:
1. Property Survey for Western Pennsylvania Conservancy No. 63-258 by Greenough & Greenough, Inc., dated 12/1963.

BENCH MARK DATA


BENCH MARK NO.	DESCRIPTION	ELEVATION
BM 1	TOP MANHOLE RIM	1274.52
BM 2	OUTLET CONTROL BOX	1281.00

LEGEND


	Random Survey Line Point
	Diverhead Line & Pole
	Electric Line - Telephone
	Watercourse

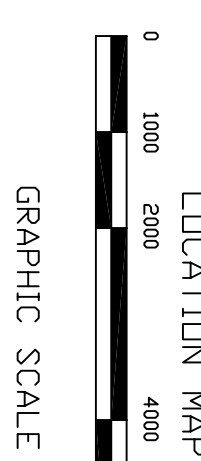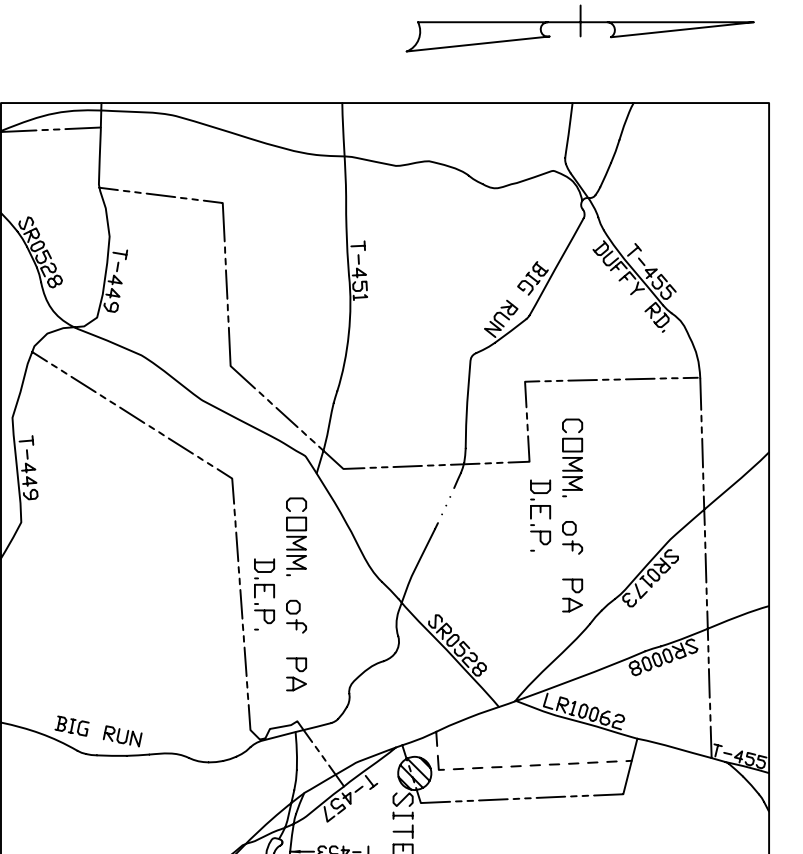


AS-BUILT PLAN
PASSIVE TREATMENT SYSTEM
at the
JENNINGS ENVIRONMENTAL EDUCATION CENTER
situate in
BRADY TOWNSHIP, BUTLER CO., PA
made for
JENNINGS WATER QUALITY IMPROVEMENT COALITION
Scale: 1"=50'
Date: 6/99
CDS Associates, Inc.
1000 Hiland Avenue
Corasopolis, PA 15106
(412) 264-4090
No. 96320B

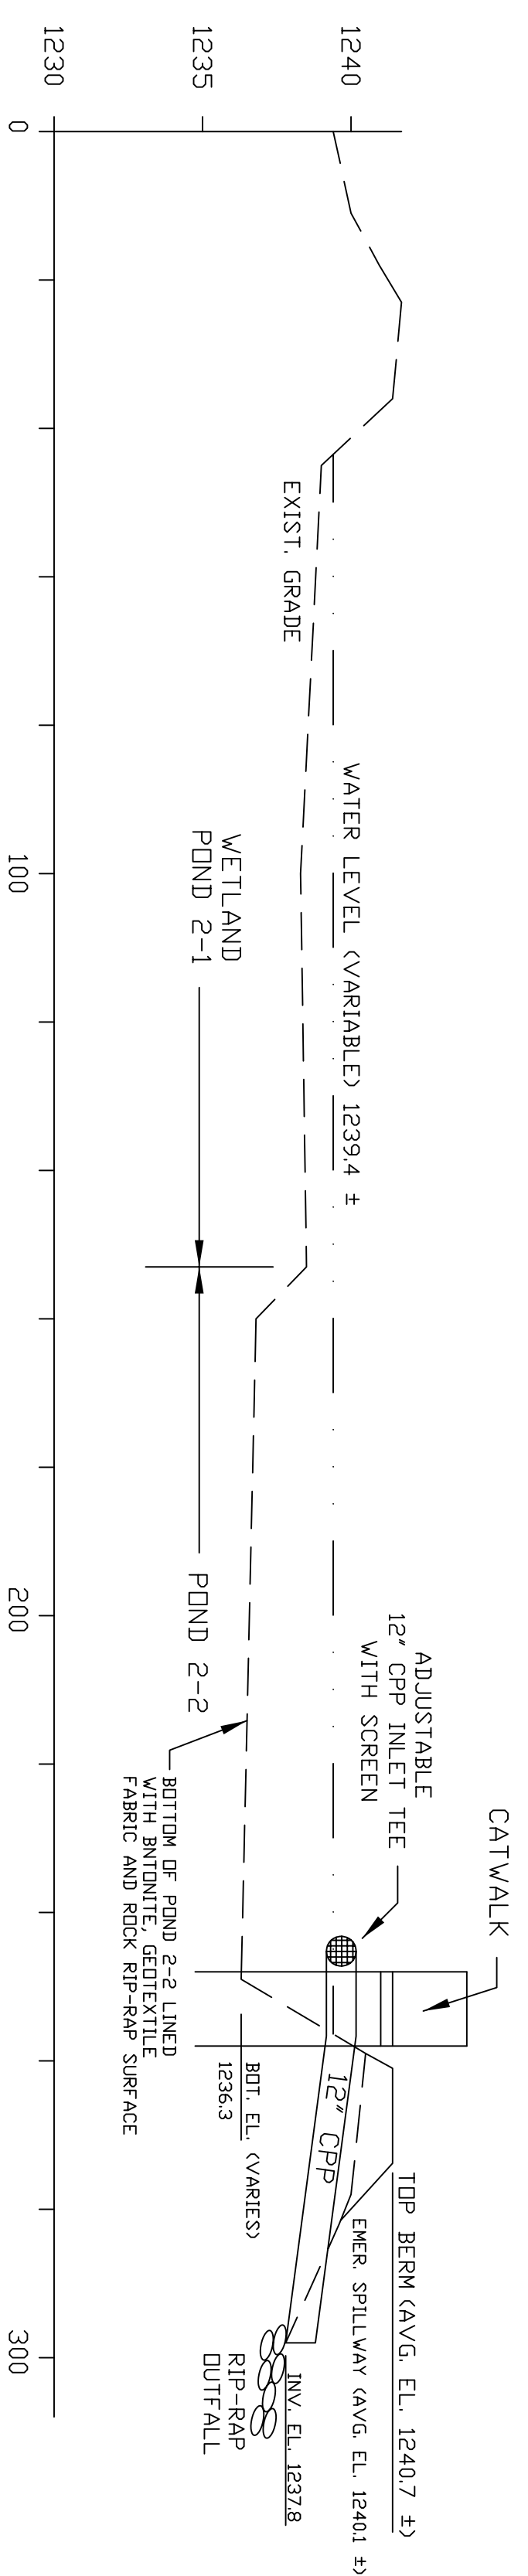


SECTION C-C
Scale: 1" = 20' Hor^z
Scale: 1" = 5' Vert^l

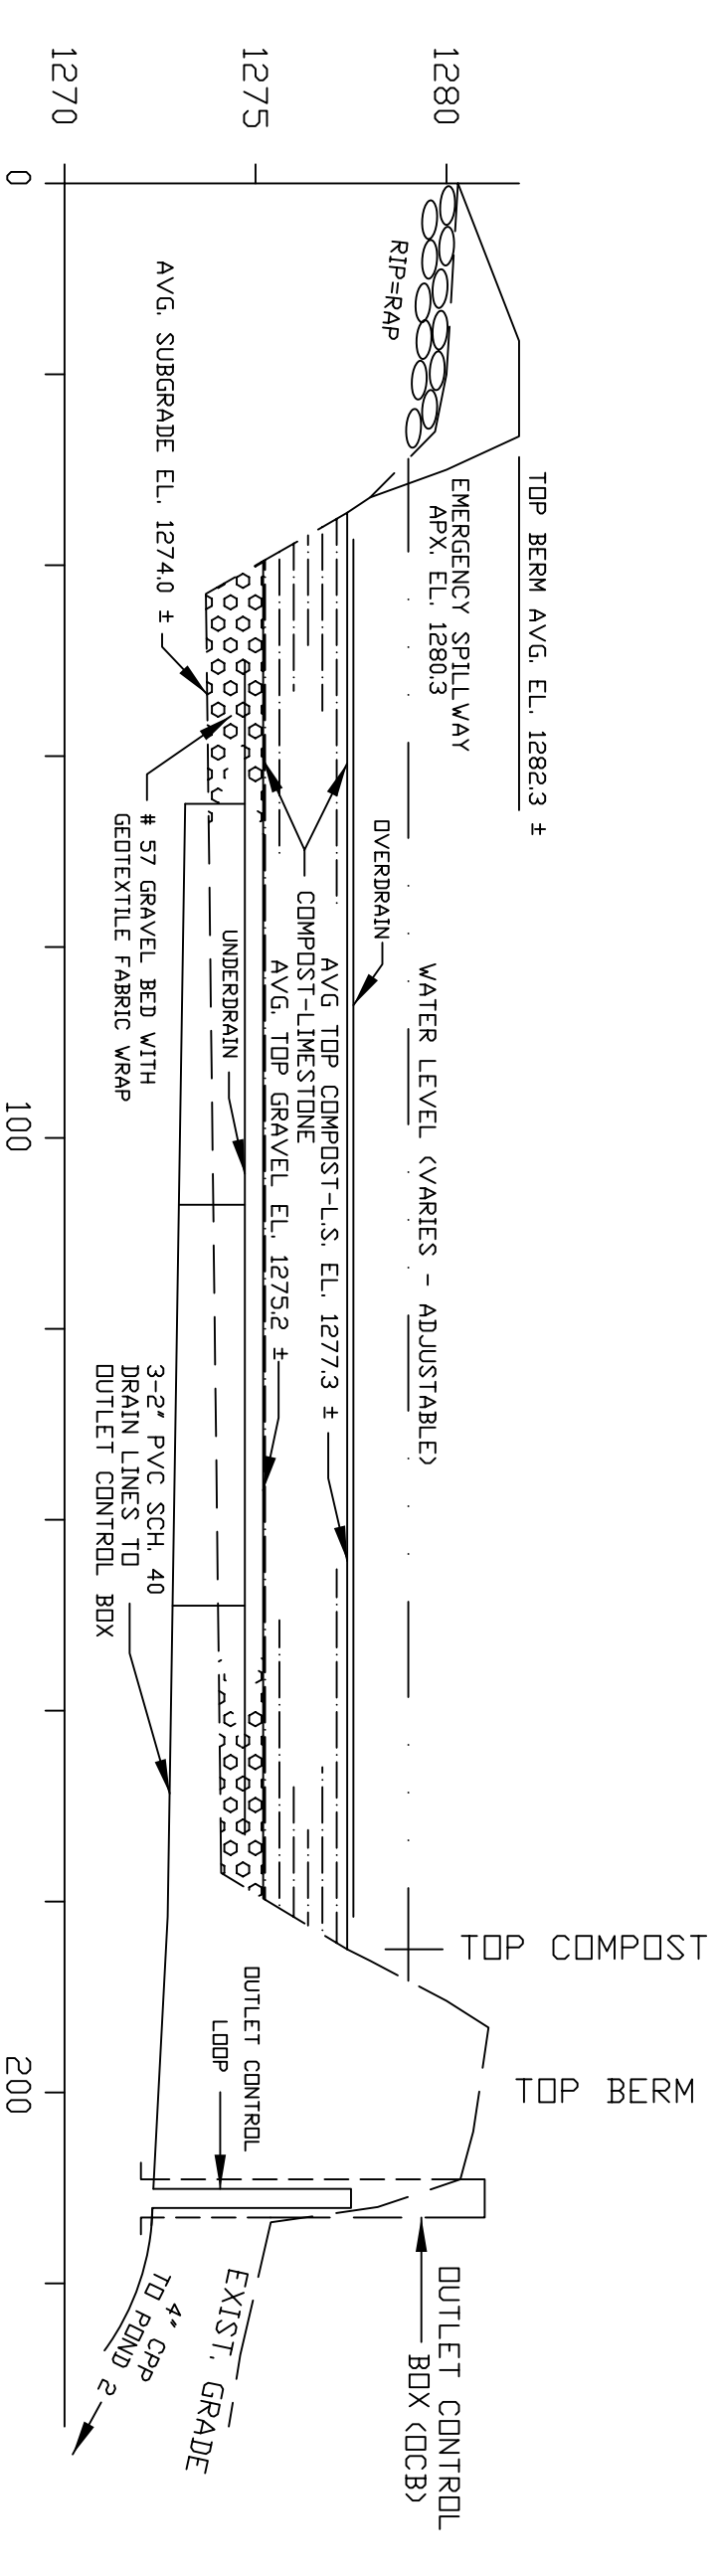


SECTION A-A
Scale: 1" = 20' Hor^z
Scale: 1" = 5' Vert^l

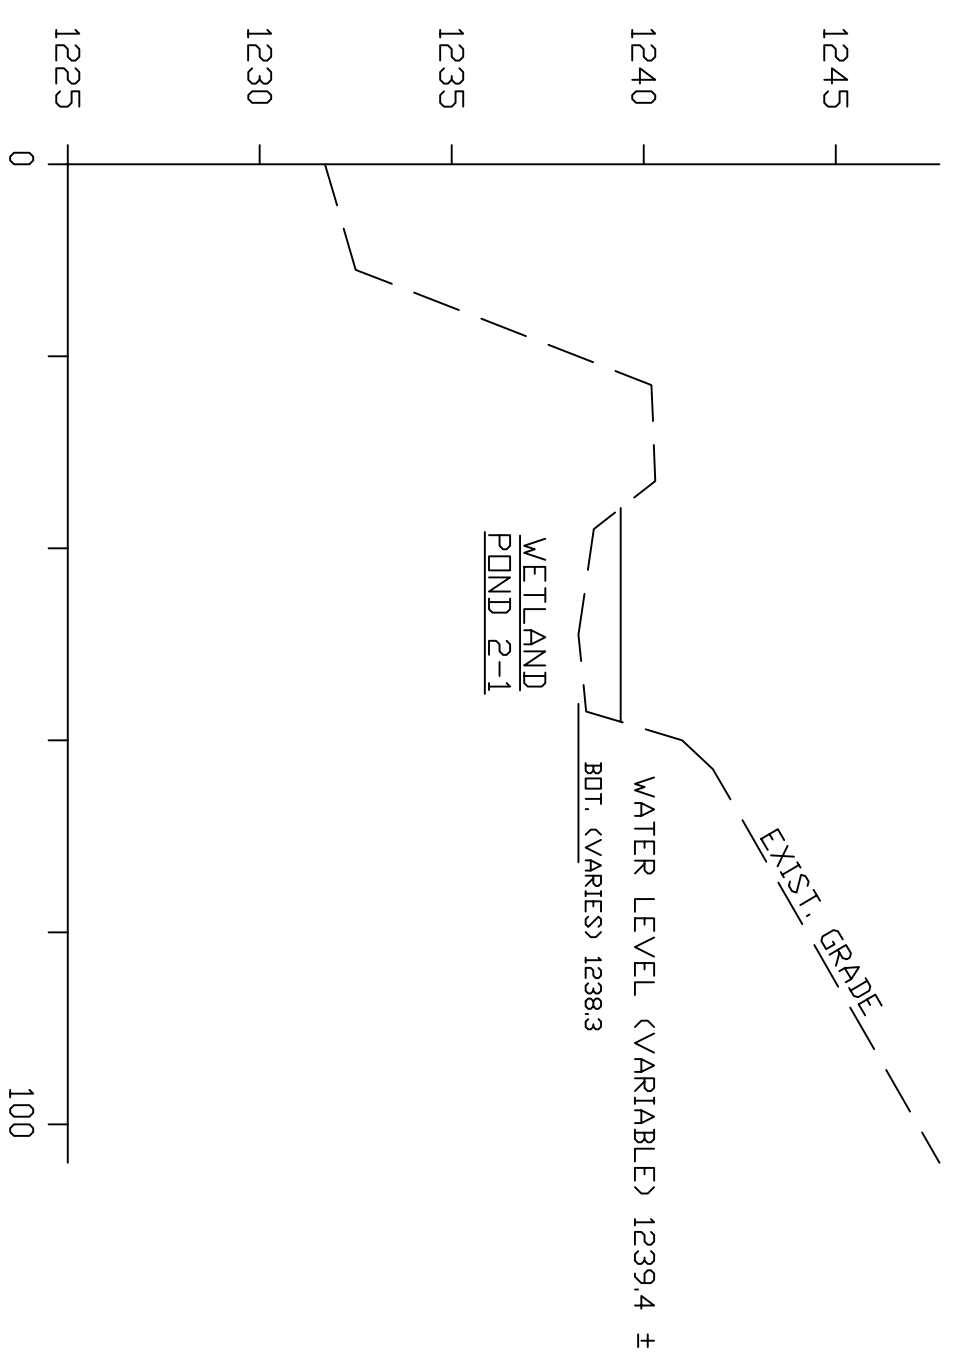


SECTION D-D
Scale: 1" = 20' Hor^z
Scale: 1" = 5' Vert^l

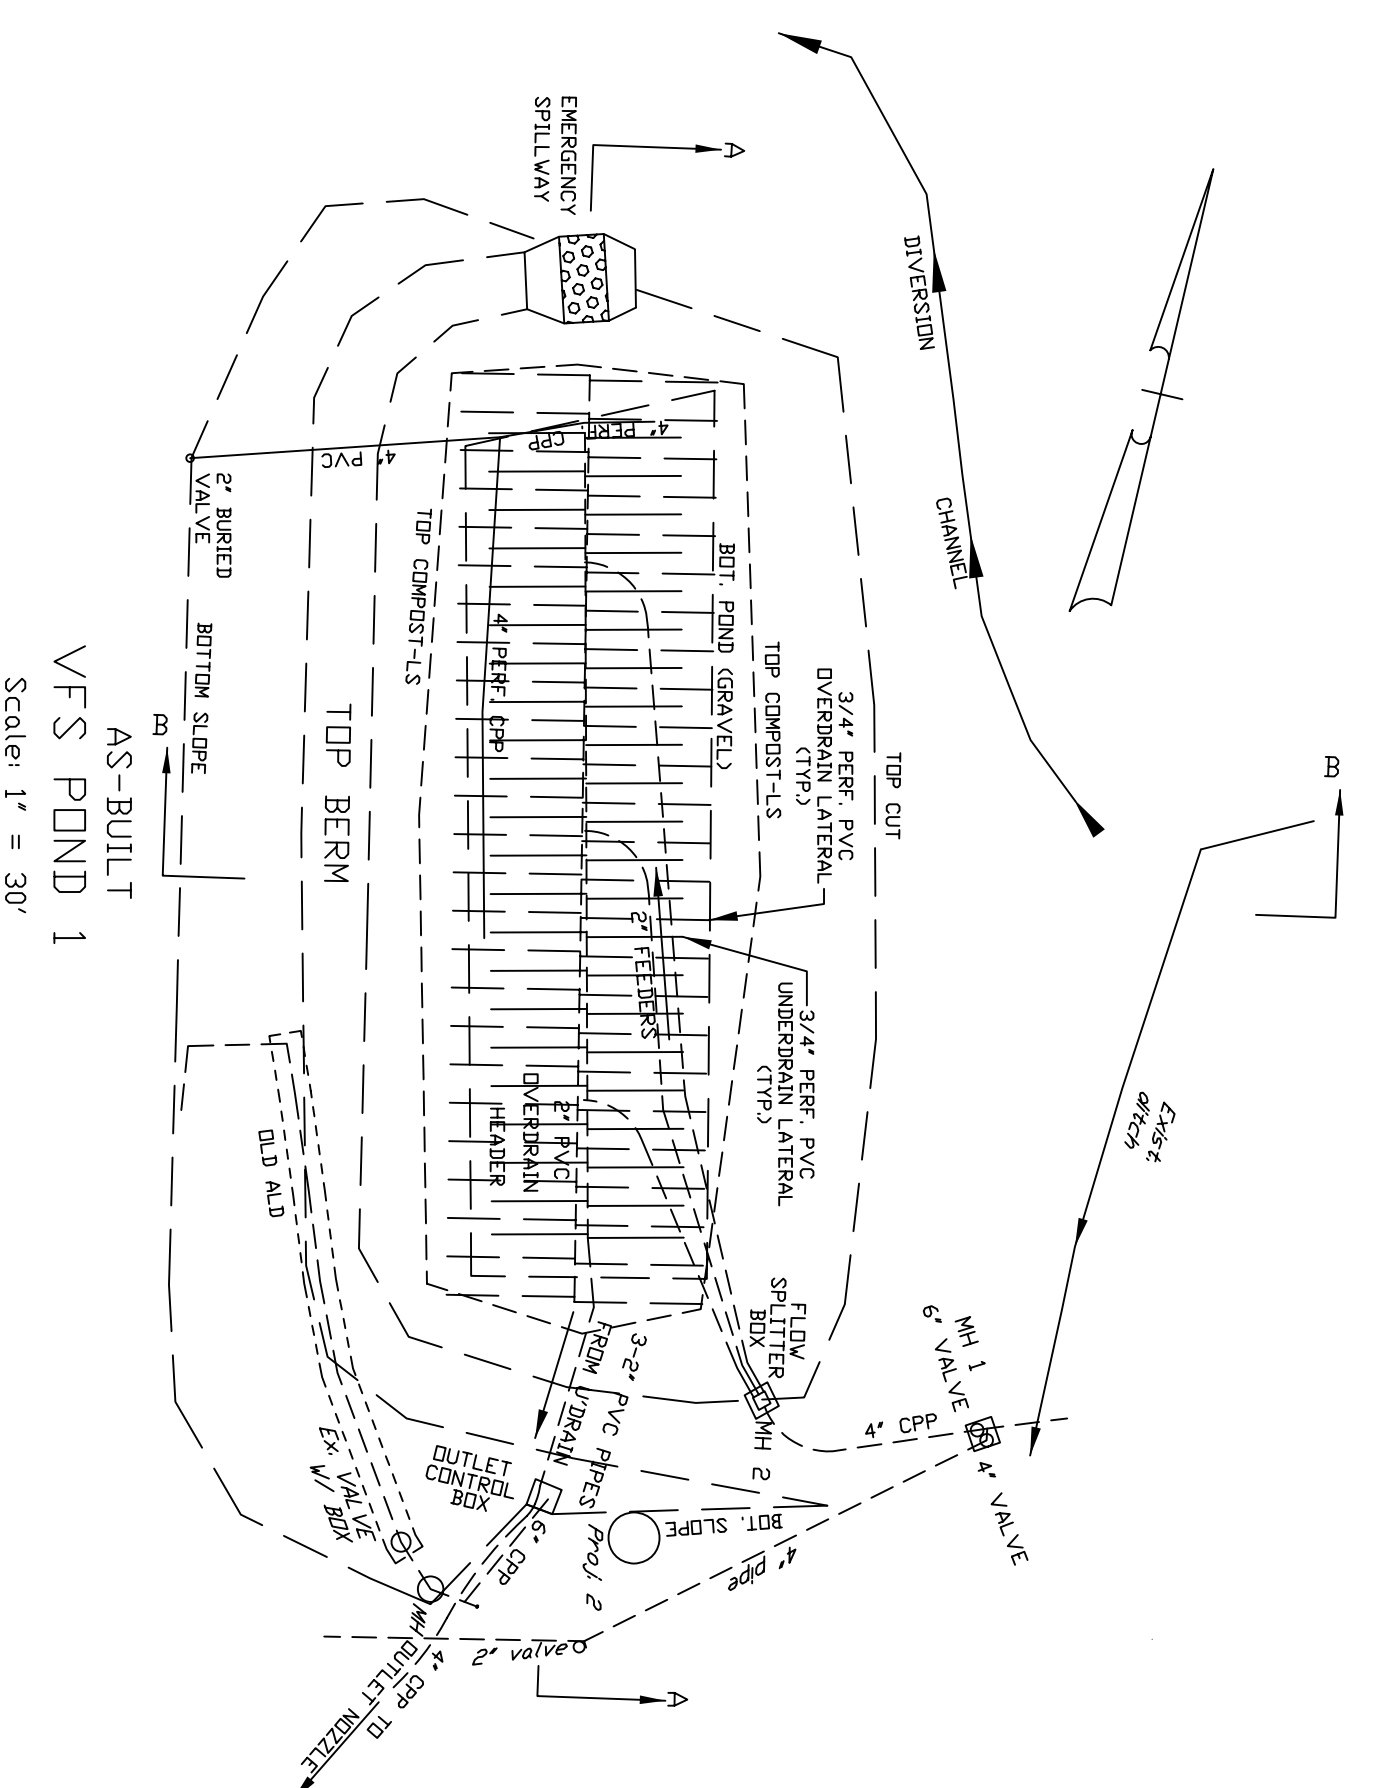

AS-BUILT
VFS POND 1
Scale: 1" = 30'

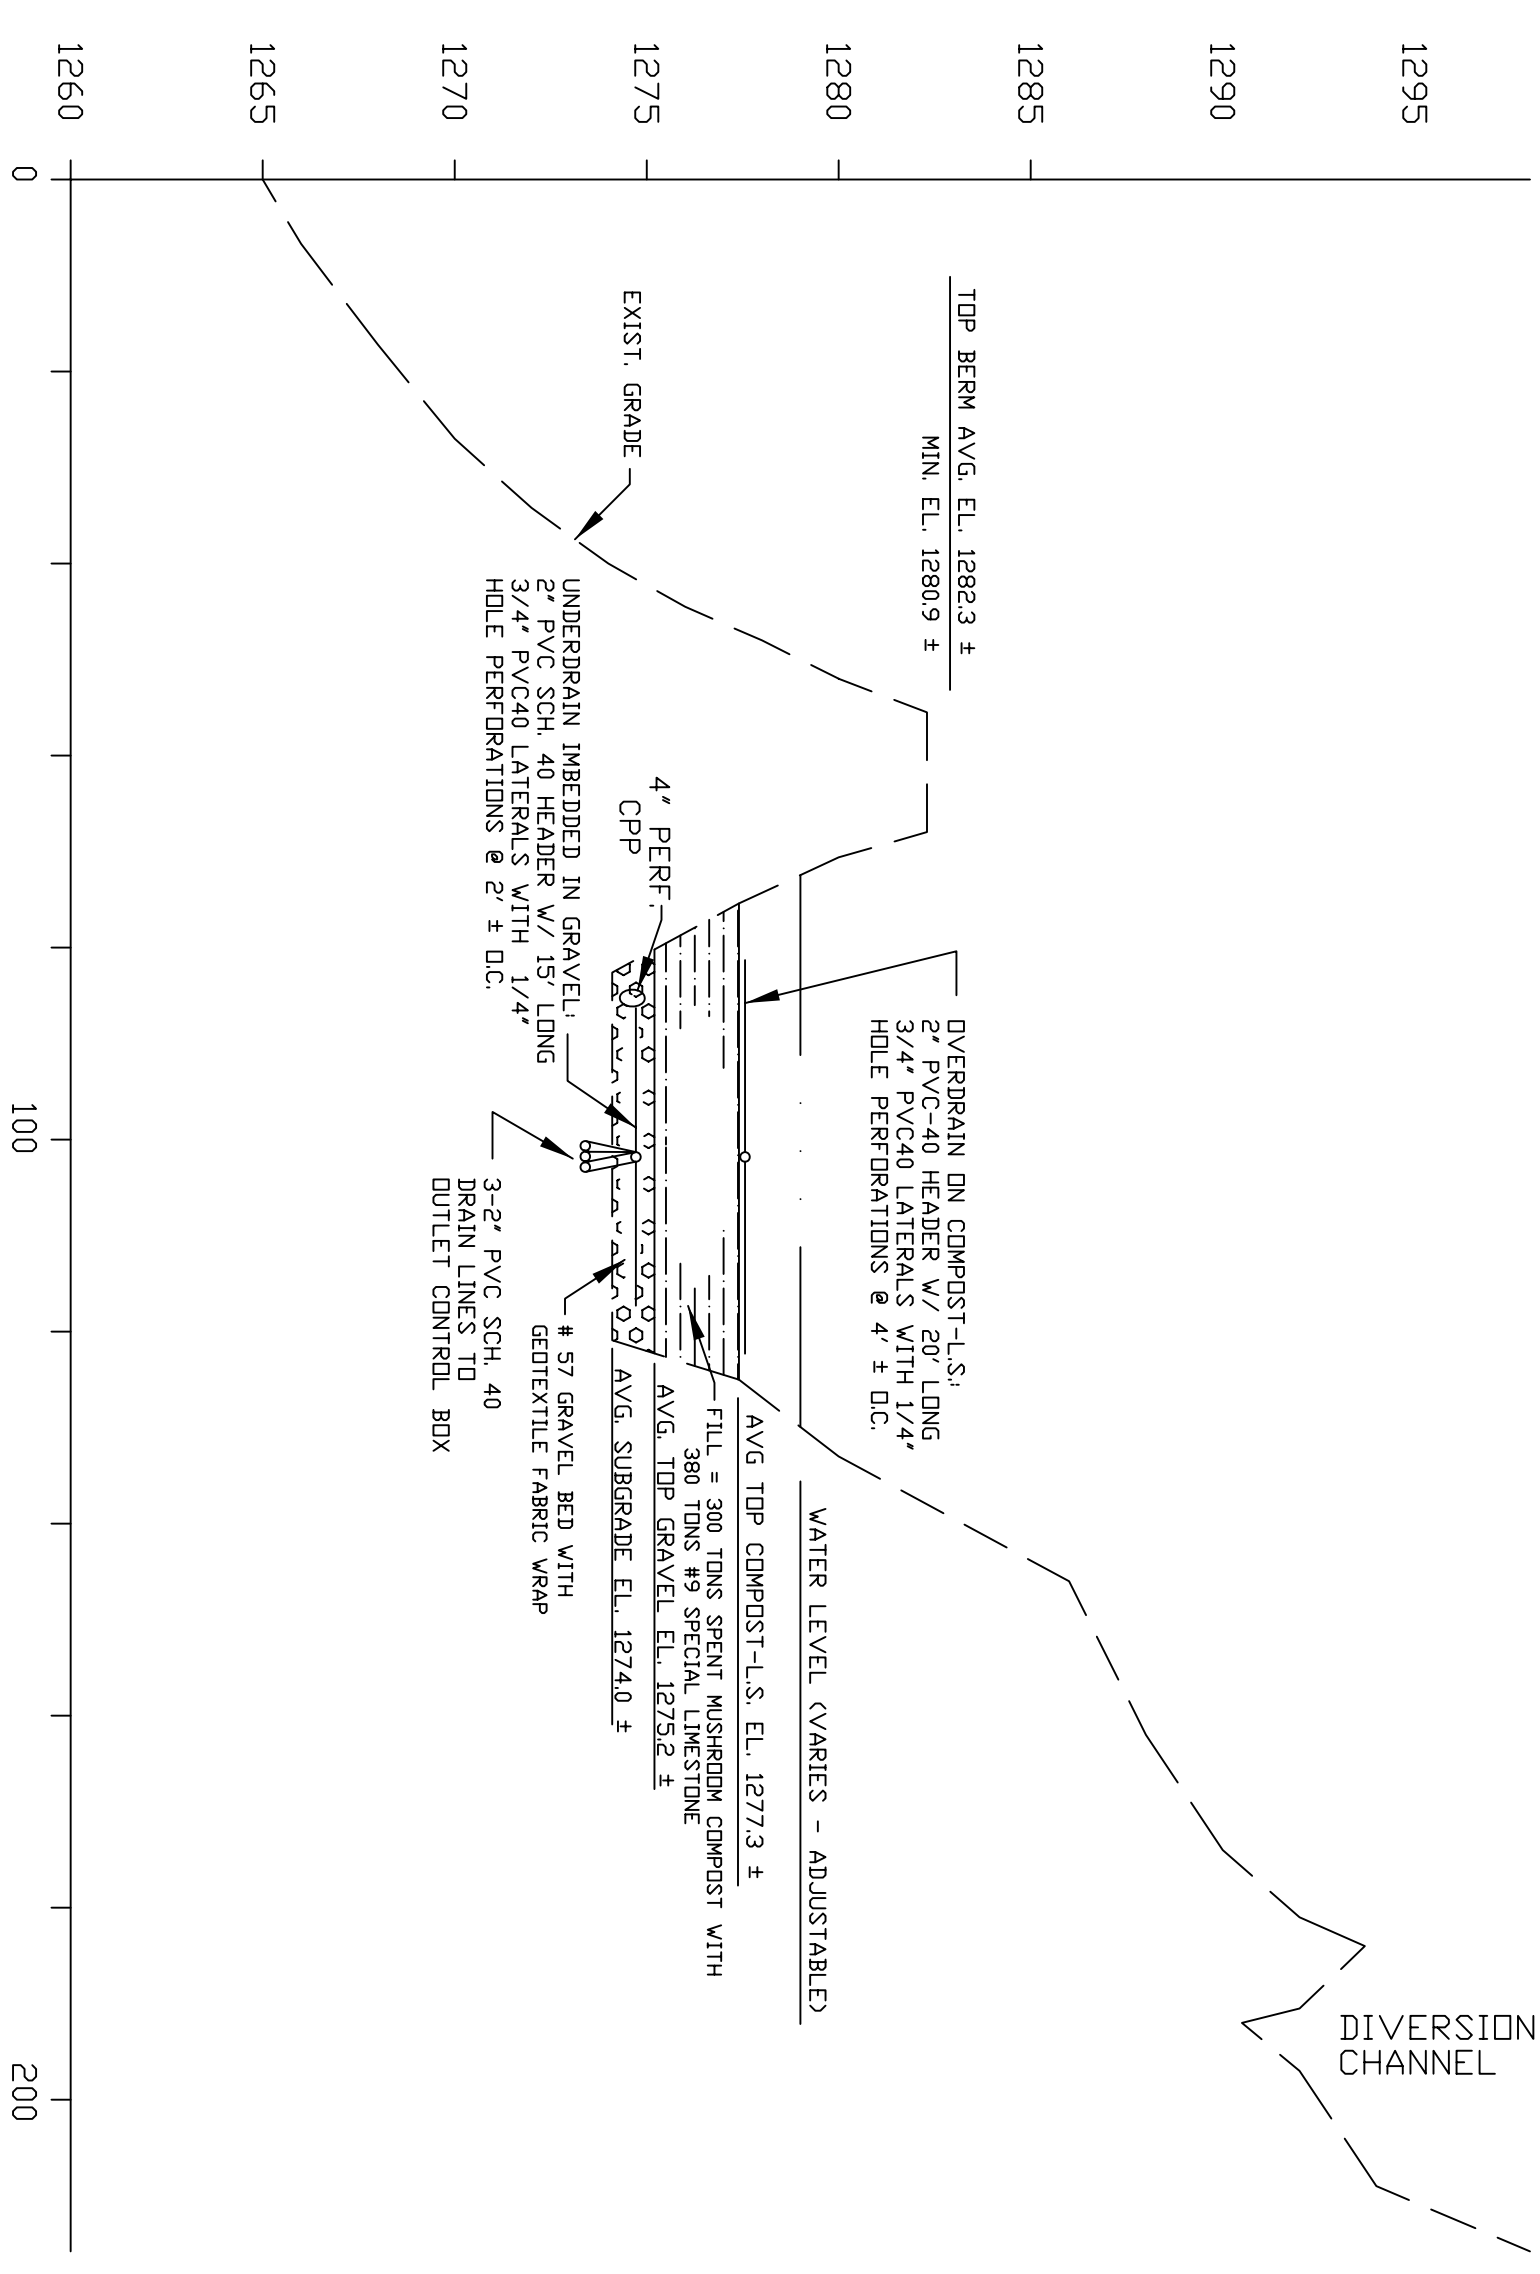

SECTION B-B
Scale: 1" = 20' Hor^z
Scale: 1" = 5' Vert^l

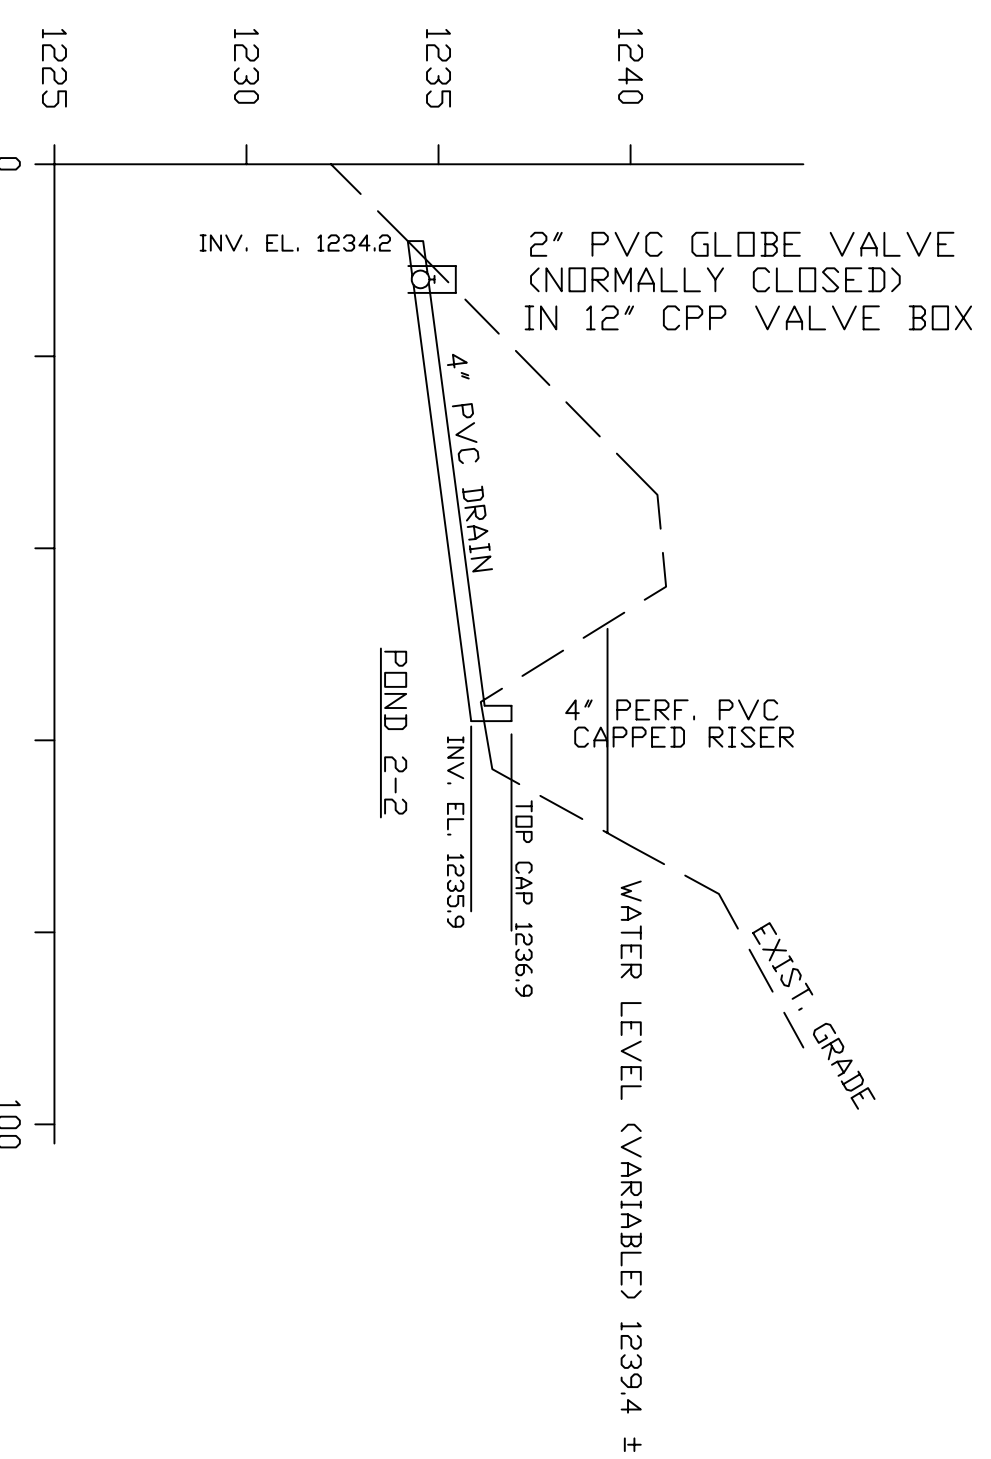

SECTION E-E
Scale: 1" = 20' Hor^z
Scale: 1" = 5' Vert^l

NOTES:

1. As-built field and office work performed predominantly by Girl Scouts of the Keystone Toll Tree Girl Scout Council under the direction of Charles D. Cooper, P.E., P.L.S.

AS-BUILT CROSS-SECTIONS
& DETAILS
PASSIVE TREATMENT SYSTEM

at the
JENNINGS ENVIRONMENTAL EDUCATION CENTER
situate in
BRADY TOWNSHIP, BUTLER CO, PA

made for
JENNINGS WATER QUALITY IMPROVEMENT COALITION

Scale: as shown Date: 6/99

CDS Associates, Inc.
1000 Highland Avenue
Corroopolis, PA 15108
(412) 264-4090
No. 96520B