




SETTLING POND & WETLAND
Horizontal Scale: None Vertical Scale: None

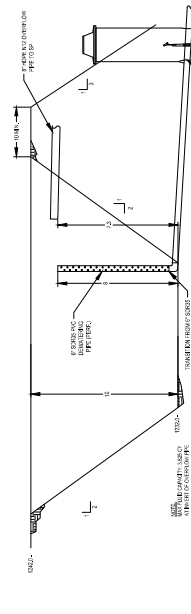


DEWATERING BASIN DETAIL
Horizontal Scale: None Vertical Scale: None

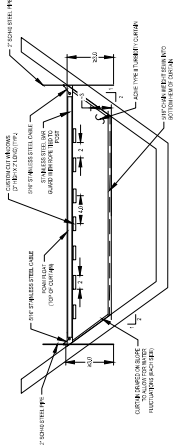


WINDOWED BAFFLE CURTAIN DETAIL
Horizontal Scale: None Vertical Scale: None

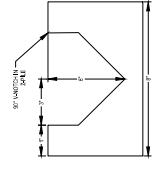

Z-PILE V-NOTCH
Horizontal Scale: None Vertical Scale: None

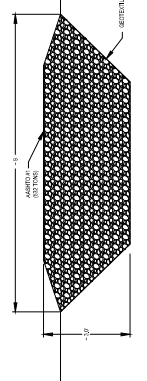


DISTRIBUTION BERM DETAIL
Horizontal Scale: None Vertical Scale: None

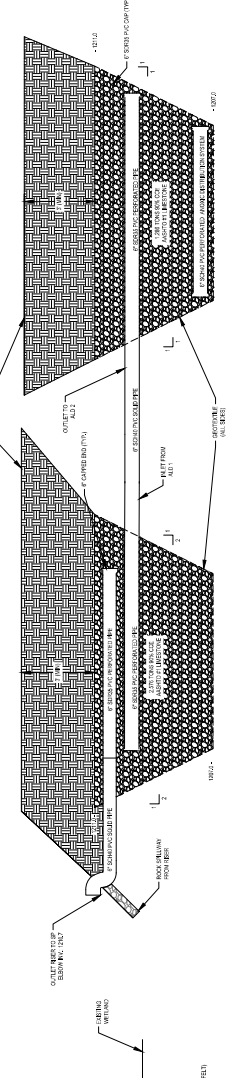


ALD 1 SECTION VIEW
Horizontal Scale: None Vertical Scale: None


ALD 2 SECTION VIEW
Horizontal Scale: None Vertical Scale: None

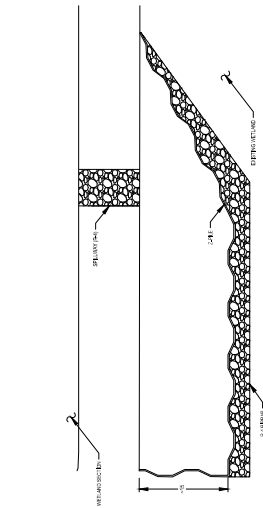

Z-PILE MOAT (TOP VIEW)
Horizontal Scale: None Vertical Scale: None

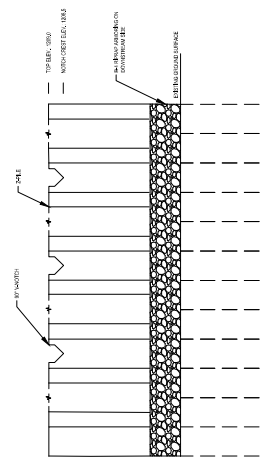

Z-PILE MOAT (FRONT VIEW)
Horizontal Scale: None Vertical Scale: None

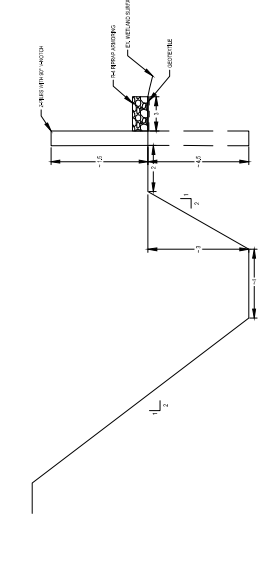

Z-PILE MOAT (SIDE VIEW)
Horizontal Scale: None Vertical Scale: None

BioMost, Inc.
1000...
313...
www.biomost.com

CLIENT:
STREAM RESTORATION, INC.
1000...
www.streamrestorationinc.com

NO.	BY	DATE	DESCRIPTION

CONTRACTOR:
CODY A. NEELY, P.E.
PROJECT REGISTERED PROFESSIONAL ENGINEER

DATE: 12/07/2023
SCALE: LVH
PROJECT: TPO

LOCATION: NONE