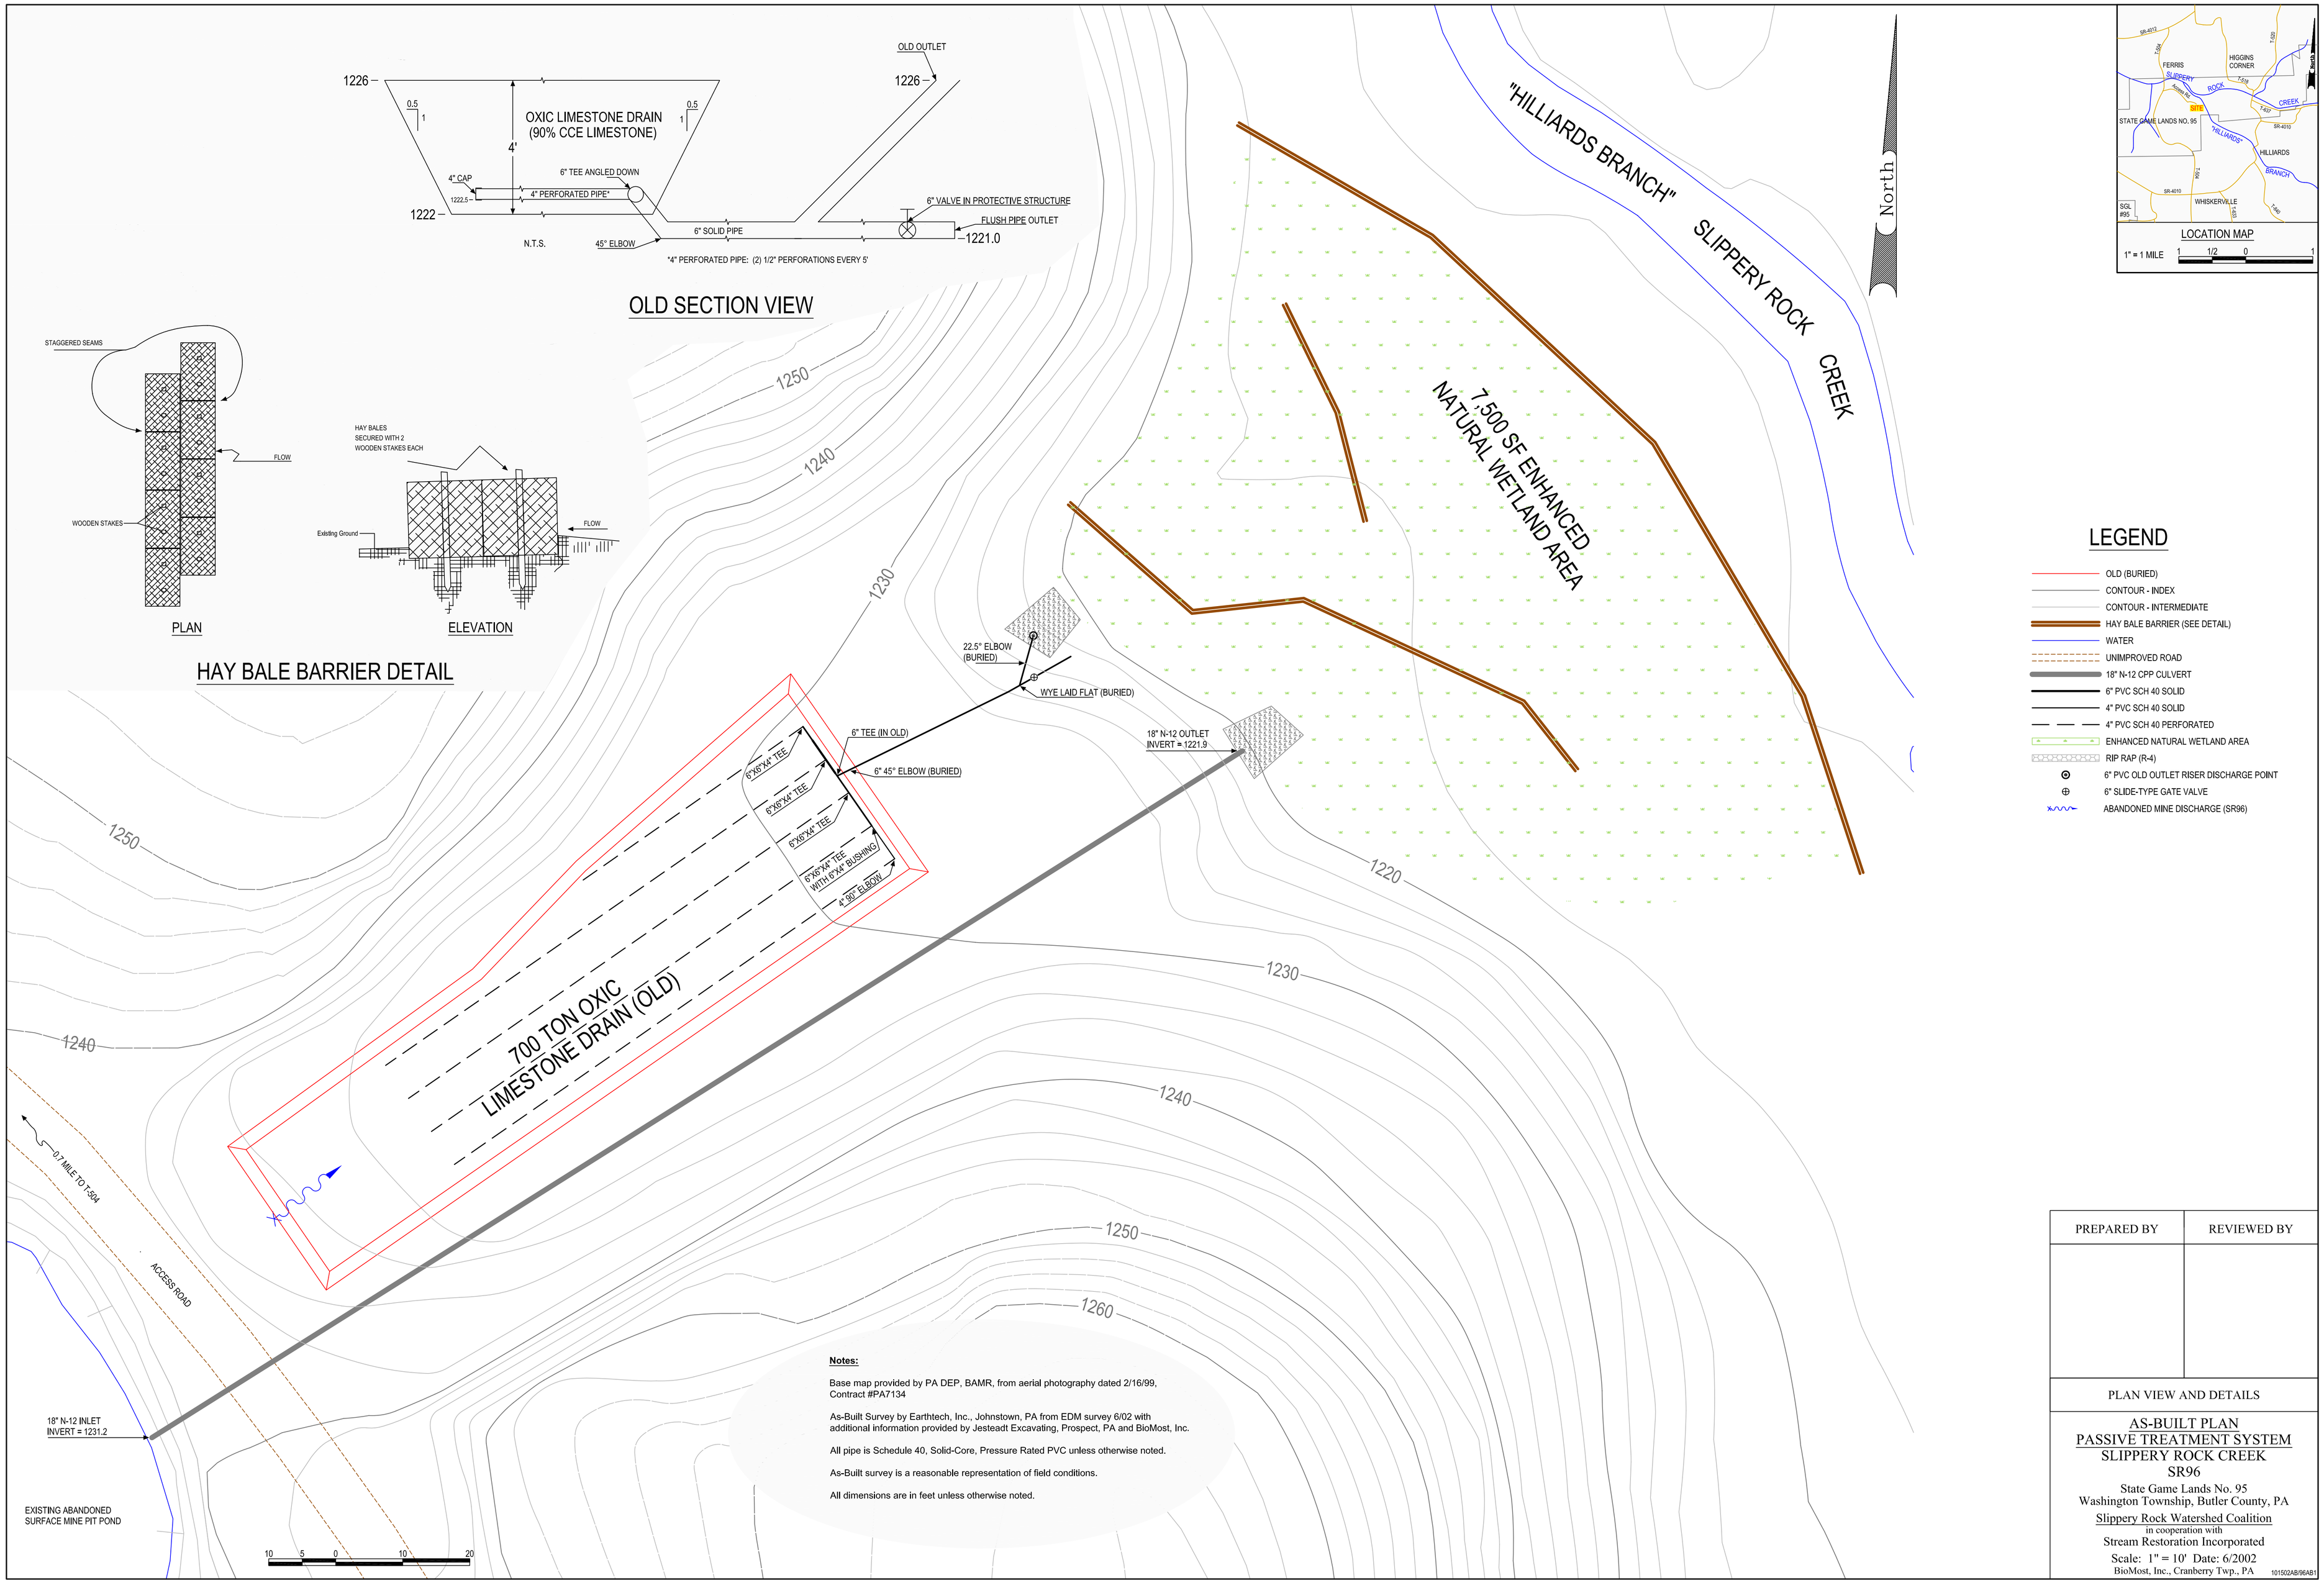

Notes:

Base map provided by PA DEP, BAMR, from aerial photography dated 2/16/99, Contract #PA7134

As-Built Survey by Earthtech, Inc., Johnstown, PA from EDM survey 6/02 with additional information provided by Jesteadt Excavating, Prospect, PA and BioMost, Inc.

All pipe is Schedule 40, Solid-Core, Pressure Rated PVC unless otherwise noted.

As-Built survey is a reasonable representation of field conditions.

All dimensions are in feet unless otherwise noted.